



画地出来形確認測量図

51街区

1441.35m²

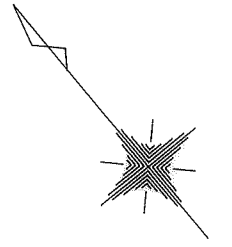

S=1:500

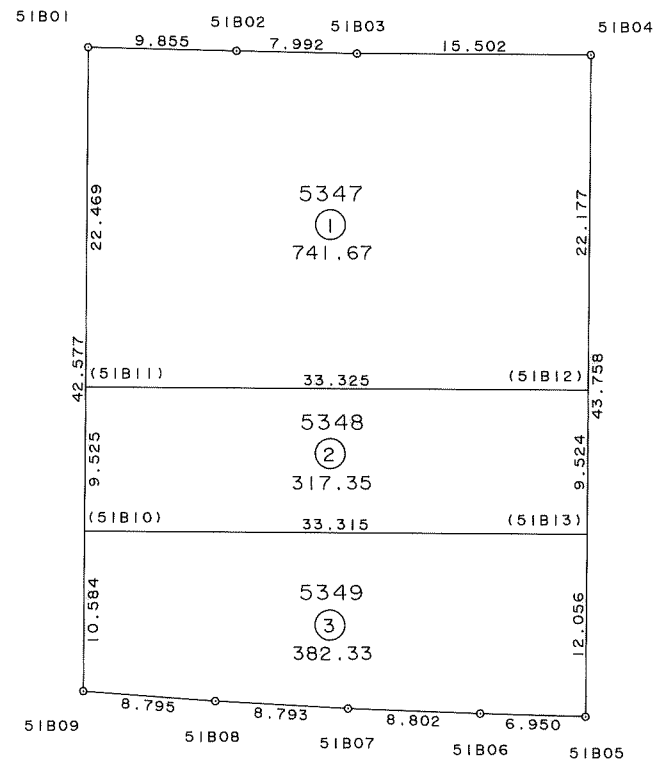

面積計算書

地番: 51-1

測点	X	Y	DX	DY	距離	方向角	夾角	倍横距	倍面積
(51B11)	30371.327	-37603.616	-21.473	25.485	33.325	130-07-00	89-59-54	25.485	-547.239405
(51B12)	30349.854	-37578.131	16.945	14.307	22.177	40-10-30	90-03-30	65.277	1106.118765
51B04	30366.799	-37563.824	9.983	-11.860	15.502	310-05-19	89-54-49	67.724	676.088692
51B03	30376.782	-37575.684	5.243	-6.032	7.992	310-59-50	180-54-31	49.832	261.269176
51B02	30382.025	-37581.716	6.484	-7.422	9.855	311-08-28	180-08-38	36.378	235.874952
51B01	30388.509	-37589.138	-17.182	-14.478	22.469	220-07-06	88-58-38	14.478	-248.760996
合計					111.320		720-00-00		1483.351184
								面積	741.675592
								坪数	224.356866

面積計算書

地番: 51-2

測点	X	Y	DX	DY	距離	方向角	夾角	倍横距	倍面積
(51B10)	30364.043	-37609.753	-21.466	25.477	33.315	130-06-59	90-00-04	25.477	-546.889282
(51B13)	30342.577	-37584.276	7.277	6.145	9.524	40-10-45	90-03-46	57.099	415.509423
(51B12)	30349.854	-37578.131	21.473	-25.485	33.325	310-07-00	89-56-15	37.759	810.799007
(51B11)	30371.327	-37603.616	-7.284	-6.137	9.525	220-06-55	89-59-55	6.137	-44.701908
合計					85.689		360-00-00		634.717240
								面積	317.358620
								坪数	96.000982

面積計算書

地番: 51-3

測点	X	Y	DX	DY	距離	方向角	夾角	倍横距	倍面積
51B09	30355.949	-37616.573	-6.111	6.325	8.795	134-00-51	93-53-48	6.325	-38.652075
51B08	30349.838	-37610.248	-5.992	6.435	8.793	132-57-30	178-56-39	19.085	-114.357320
51B07	30343.846	-37603.813	-5.882	6.548	8.802	131-55-59	178-58-29	32.068	-188.623976
51B06	30337.964	-37597.265	-4.599	5.211	6.950	131-25-49	179-29-50	43.827	-201.560373
51B05	30333.365	-37592.054	9.212	7.778	12.056	40-10-32	88-44-43	56.816	523.388992
(51B13)	30342.577	-37584.276	21.466	-25.477	33.315	310-06-59	89-56-27	39.117	839.685522
(51B10)	30364.043	-37609.753	-8.094	-6.820	10.584	220-07-03	90-00-04	6.820	-55.201080
合計					89.295		900-00-00		764.679690
								面積	382.339845
								坪数	115.657803