



画地出来形確認測量図

63街区

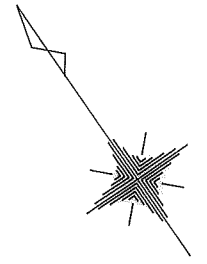

S=1:500

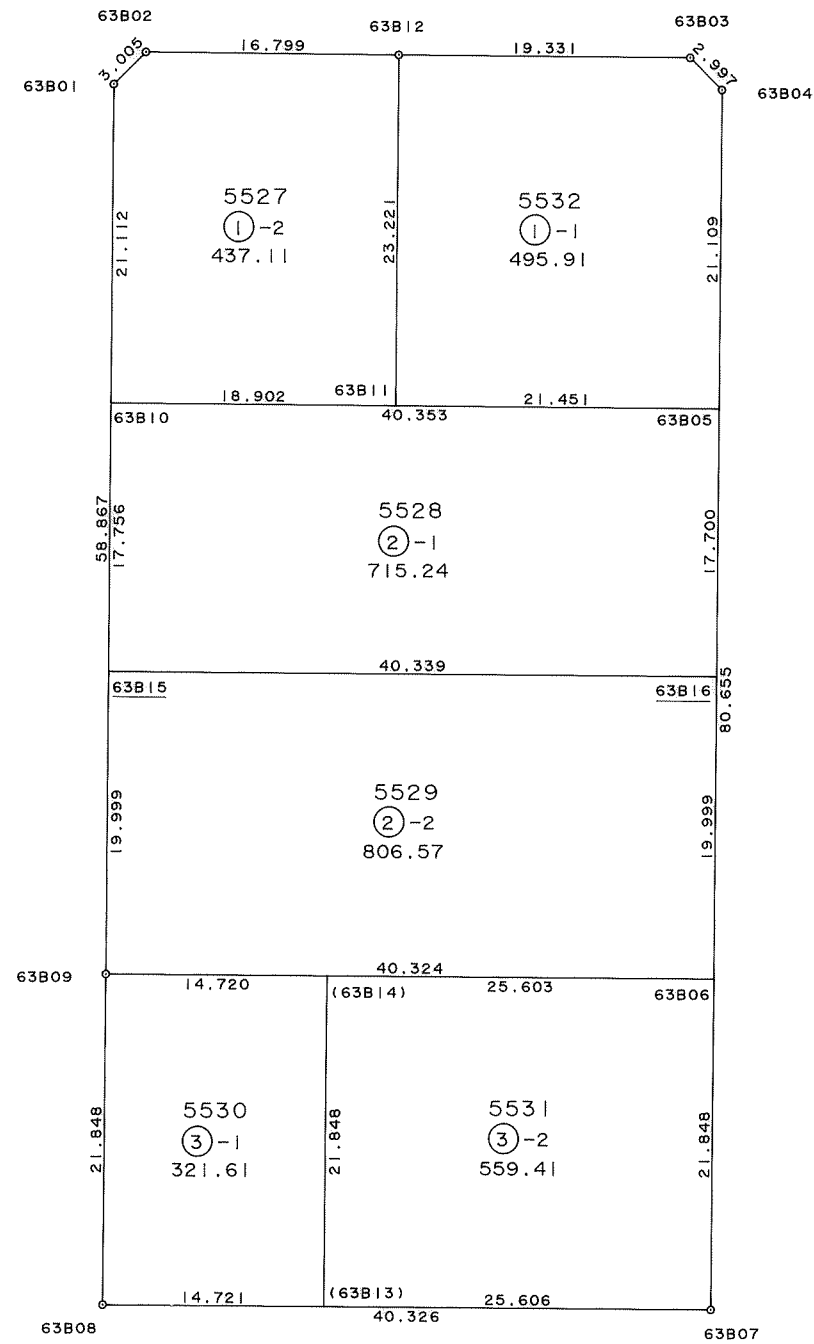

3335.85m²

面積計算書

地番: 63-1-1

測点	X	Y	DX	DY	距離	方向角	夾角	倍横距	倍面積
63B11	30066.671	-37335.407	-12.377	17.520	21.451	125-14-21	90-04-37	17.520	-216.845040
63B05	30054.294	-37317.887	17.254	12.161	21.109	35-10-37	89-56-16	47.201	814.406054
63B04	30071.548	-37305.726	2.951	-0.521	2.997	349-59-15	134-48-38	58.841	173.639791
63B03	30074.499	-37306.247	11.156	-15.787	19.331	305-14-50	135-15-35	42.533	474.498148
63B12	30085.655	-37322.034	-18.984	-13.373	23.221	215-09-44	89-54-54	13.373	-253.873032
合計					88.109		540-00-00		991.825921
								面積	495.912960
								坪数	150.013670

面積計算書

地番: 63-1-2

測点	X	Y	DX	DY	距離	方向角	夾角	倍横距	倍面積
63B10	30077.577	-37350.845	-10.906	15.438	18.902	125-14-20	90-06-18	15.438	-168.366828
63B11	30066.671	-37335.407	18.984	13.373	23.221	35-09-44	89-55-24	44.249	840.023016
63B12	30085.655	-37322.034	9.718	-13.703	16.799	305-20-38	90-10-54	43.919	426.804842
63B02	30095.373	-37335.737	-0.530	-2.958	3.005	259-50-31	134-29-53	27.258	-14.446740
63B01	30094.843	-37338.695	-17.266	-12.150	21.112	215-08-02	135-17-31	12.150	-209.781900
合計					83.039		540-00-00		874.232390
								面積	437.116195
								坪数	132.227648

面積計算書

地番: 63-2-1

測点	X	Y	DX	DY	距離	方向角	夾角	倍横距	倍面積
63B15	30063.056	-37361.064	-23.229	32.980	40.339	125-09-30	90-01-22	32.980	-766.092420
63B16	30039.827	-37328.084	14.467	10.197	17.700	35-10-41	90-01-11	76.157	1101.763319
63B05	30054.294	-37317.887	23.283	-32.958	40.353	305-14-21	90-03-40	53.396	1243.219068
63B10	30077.577	-37350.845	-14.521	-10.219	17.756	215-08-08	89-53-47	10.219	-148.390099
合計					116.148		360-00-00		1430.499868
								面積	715.249934
								坪数	216.363105

面積計算書

地番: 63-2-2

測点	X	Y	DX	DY	距離	方向角	夾角	倍横距	倍面積
63B09	30046.701	-37372.573	-23.220	32.967	40.324	125-09-31	90-01-29	32.967	-765.493740
63B06	30023.481	-37339.606	16.346	11.522	19.999	35-10-46	90-01-15	77.456	1266.095776
63B16	30039.827	-37328.084	23.229	-32.980	40.339	305-09-30	89-58-44	55.998	1300.777542
63B15	30063.056	-37361.064	-16.355	-11.509	19.999	215-08-02	89-58-32	11.509	-188.229695
合計					120.661		360-00-00		1613.149883
								面積	806.574941
								坪数	243.988919

面積計算書

地番: 63-3-1

測点	X	Y	DX	DY	距離	方向角	夾角	倍横距	倍面積
63B08	30028.845	-37385.162	-8.477	12.035	14.721	125-09-34	89-58-28	12.035	-102.020695
(63B13)	30020.368	-37373.127	17.857	12.589	21.848	35-11-00	90-01-26	36.659	654.619763
(63B14)	30038.225	-37360.538	8.476	-12.035	14.720	305-09-22	89-58-22	37.213	315.417388
63B09	30046.701	-37372.573	-17.856	-12.589	21.848	215-11-06	90-01-44	12.589	-224.789184
合計					73.137		360-00-00		643.227272
								面積	321.613636
								坪数	97.288124

面積計算書

地番: 63-3-2

測点	X	Y	DX	DY	距離	方向角	夾角	倍横距	倍面積
(63B13)	30020.368	-37373.127	-14.745	20.934	25.606	125-09-33	89-58-33	20.934	-308.671830
63B07	30005.623	-37352.193	17.858	12.587	21.848	35-10-40	90-01-07	54.455	972.457390
63B06	30023.481	-37339.606	14.744	-20.932	25.603	305-09-36	89-58-56	46.110	679.845840
(63B14)	30038.225	-37360.538	-17.857	-12.589	21.848	215-11-00	90-01-24	12.589	-224.801773
合計					94.905		360-00-00		1118.829627
								面積	559.414813
								坪数	169.222980