



画地出来形確認測量図

67街区

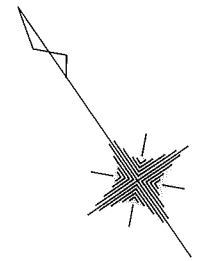

S=1:500

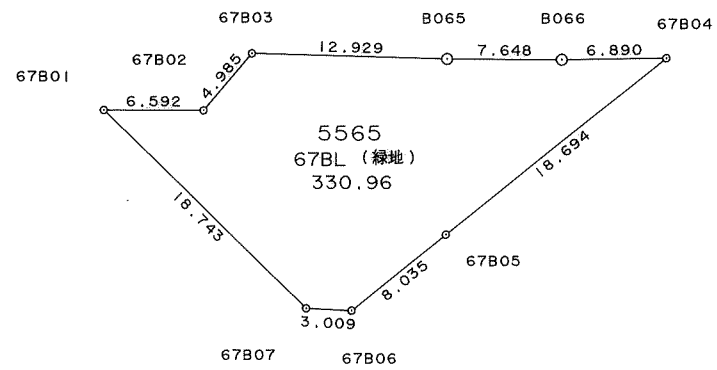

面積計算書

地番: 67BL

測点	X	Y	DX	DY	距離	方向角	夾角	倍横距	倍面積
67B01	30177.415	-37296.468	-18.401	3.565	18.743	169-02-07	44-07-23	3.565	-65.599565
67B07	30159.014	-37292.903	-1.840	2.381	3.009	127-41-47	138-39-40	9.511	-17.500240
67B06	30157.174	-37290.522	0.558	8.016	8.035	86-01-05	138-19-18	19.908	11.108664
67B05	30157.732	-37282.506	1.255	18.652	18.694	86-09-02	180-07-57	46.576	58.452880
67B04	30158.987	-37263.854	3.851	-5.713	6.890	303-58-59	37-49-57	59.515	229.192265
B066	30162.838	-37269.567	4.392	-6.261	7.648	305-02-57	181-03-58	47.541	208.800072
B065	30167.230	-37275.828	7.668	-10.410	12.929	306-22-31	181-19-34	30.870	236.711160
67B03	30174.898	-37286.238	-1.256	-4.824	4.985	255-24-22	129-01-51	15.636	-19.638816
67B02	30173.642	-37291.062	3.773	-5.406	6.592	304-54-44	229-30-22	5.406	20.396838
合計					87.525		1260-00-00		661.923258
								面積	330.961629
								坪数	100.115892