



画地出来形確認測量図

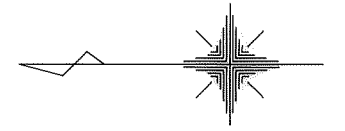

S=1:500

4065.17m<sup>2</sup>

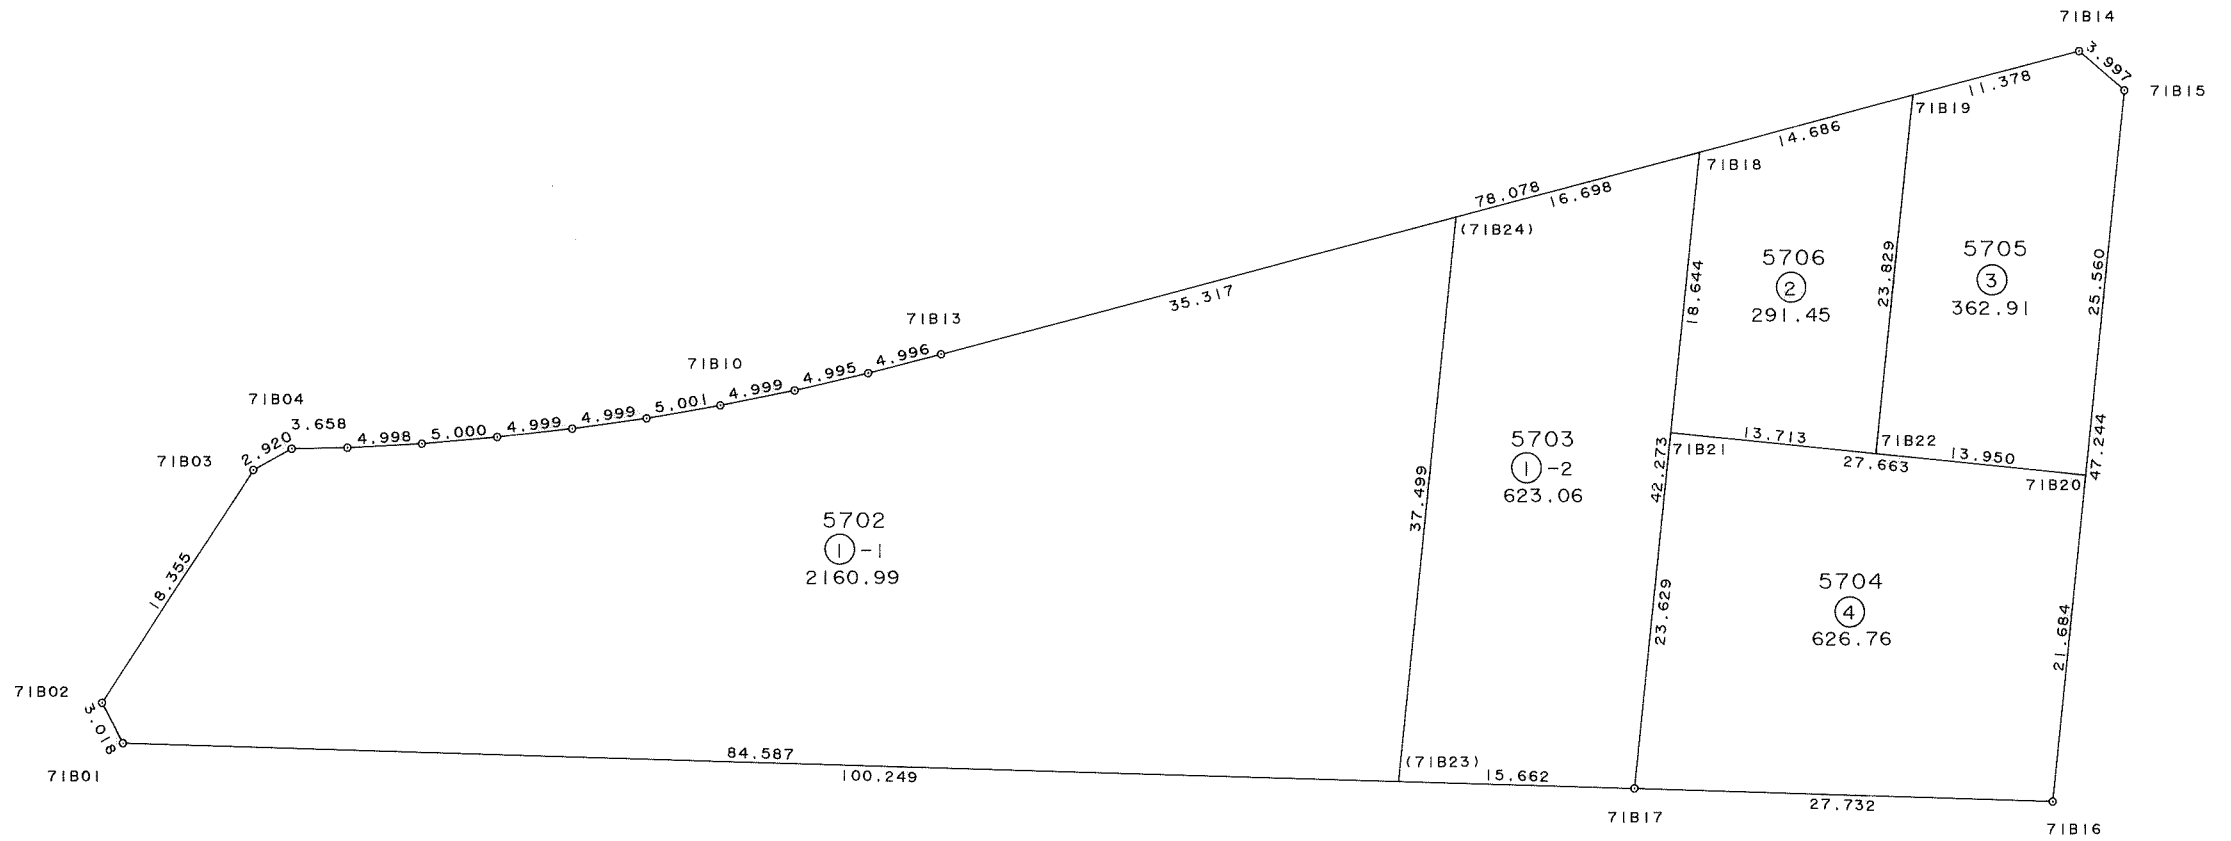

面積計算書

地番: 71-1-1

測点	X	Y	DX	DY	距離	方向角	夾角	倍横距	倍面積
71B02	30058.451	-37133.181	-1.412	-2.667	3.018	242-06-06	119-06-31	-2.667	3.765804
71B01	30057.039	-37135.848	-84.550	-2.493	84.587	181-41-20	119-35-14	-7.827	661.772850
(71B23)	29972.489	-37138.341	-3.795	37.306	37.499	95-48-31	94-07-11	26.986	-102.411870
(71B24)	29968.694	-37101.035	34.132	-9.070	35.317	345-07-07	69-18-36	55.222	1884.837304
71B13	30002.826	-37110.105	4.835	-1.258	4.996	345-24-57	180-17-50	44.894	217.062490
71B12	30007.661	-37111.363	4.863	-1.140	4.995	346-48-24	181-23-27	42.496	206.658048
71B11	30012.524	-37112.503	4.899	-0.995	4.999	348-31-09	181-42-45	40.361	197.728539
71B10	30017.423	-37113.498	4.927	-0.857	5.001	350-07-58	181-36-49	38.509	189.733843
71B09	30022.350	-37114.355	4.953	-0.680	4.999	352-10-58	182-03-00	36.972	183.122316
71B08	30027.303	-37115.035	4.968	-0.555	4.999	353-37-32	181-26-34	35.737	177.541416
71B07	30032.271	-37115.590	4.980	-0.442	5.000	354-55-41	181-18-09	34.740	173.005200
71B06	30037.251	-37116.032	4.990	-0.275	4.998	356-50-44	181-55-03	34.023	169.774770
71B05	30042.241	-37116.307	3.657	-0.071	3.658	358-53-16	182-02-32	33.677	123.156789
71B04	30045.898	-37116.378	2.558	-1.408	2.920	331-10-13	152-16-57	32.198	82.362484
71B03	30048.456	-37117.786	9.995	-15.395	18.355	302-59-35	151-49-22	15.395	153.873025
合計					225.341		2340-00-00		4321.983008
								面積 坪数	2160.991504 653.699929

面積計算書

地番: 71-1-2

測点	X	Y	DX	DY	距離	方向角	夾角	倍横距	倍面積
(71B23)	29972.489	-37138.341	-15.655	-0.462	15.662	181-41-25	85-52-54	-0.462	7.232610
71B17	29956.834	-37138.803	-4.278	42.056	42.273	95-48-30	94-07-05	41.132	-175.962696
71B18	29952.556	-37096.747	16.138	-4.288	16.698	345-07-12	69-18-42	78.900	1273.288200
(71B24)	29968.694	-37101.035	3.795	-37.306	37.499	275-48-31	110-41-19	37.306	141.576270
合計					112.132		360-00-00		1246.134384
								面積 坪数	623.067192 188.477825

面積計算書

地番: 71-2

測点	X	Y	DX	DY	距離	方向角	夾角	倍横距	倍面積
71B21	29954.443	-37115.295	-13.643	-1.384	13.713	185-47-33	89-59-00	-1.384	18.881912
71B22	29940.800	-37116.679	-2.437	23.704	23.829	95-52-12	90-04-39	20.936	-51.021032
71B19	29938.363	-37092.975	14.193	-3.772	14.686	345-07-01	69-14-49	40.868	580.039524
71B18	29952.556	-37096.747	1.887	-18.548	18.644	275-48-33	110-41-32	18.548	35.000076
合計					70.872		360-00-00		582.900480
								面積 坪数	291.450240 88.163697

面積計算書

地番: 71-3

測点	X	Y	DX	DY	距離	方向角	夾角	倍横距	倍面積
71B22	29940.800	-37116.679	-13.879	-1.408	13.950	185-47-34	89-55-22	-1.408	19.541632
71B20	29926.921	-37118.087	-2.586	25.429	25.560	95-48-24	90-00-50	22.613	-58.477218
71B15	29924.335	-37092.658	3.032	2.605	3.997	40-40-05	124-51-41	50.647	153.561704
71B14	29927.367	-37090.053	10.996	-2.922	11.378	345-07-07	124-27-02	50.330	553.428680
71B19	29938.363	-37092.975	2.437	-23.704	23.829	275-52-12	110-45-05	23.704	57.766648
合計					78.714		540-00-00		725.821446
								面積 坪数	362.910723 109.780493

面積計算書

地番: 71-4

測点	X	Y	DX	DY	距離	方向角	夾角	倍横距	倍面積
71B17	29956.834	-37138.803	-27.719	-0.857	27.732	181-46-15	85-57-48	-0.857	23.755183
71B16	29929.115	-37139.660	-2.194	21.573	21.684	95-48-26	94-02-11	19.859	-43.570646
71B20	29926.921	-37118.087	27.522	2.792	27.663	5-47-33	89-59-07	44.224	1217.132928
71B21	29954.443	-37115.295	2.391	-23.508	23.629	275-48-27	90-00-54	23.508	56.207628
合計					100.708		360-00-00		1253.525093
								面積 坪数	626.762546 189.595670