



画地出来形確認測量図

73街区

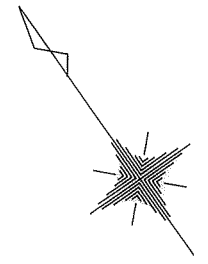

S=1:500

3442.03m²

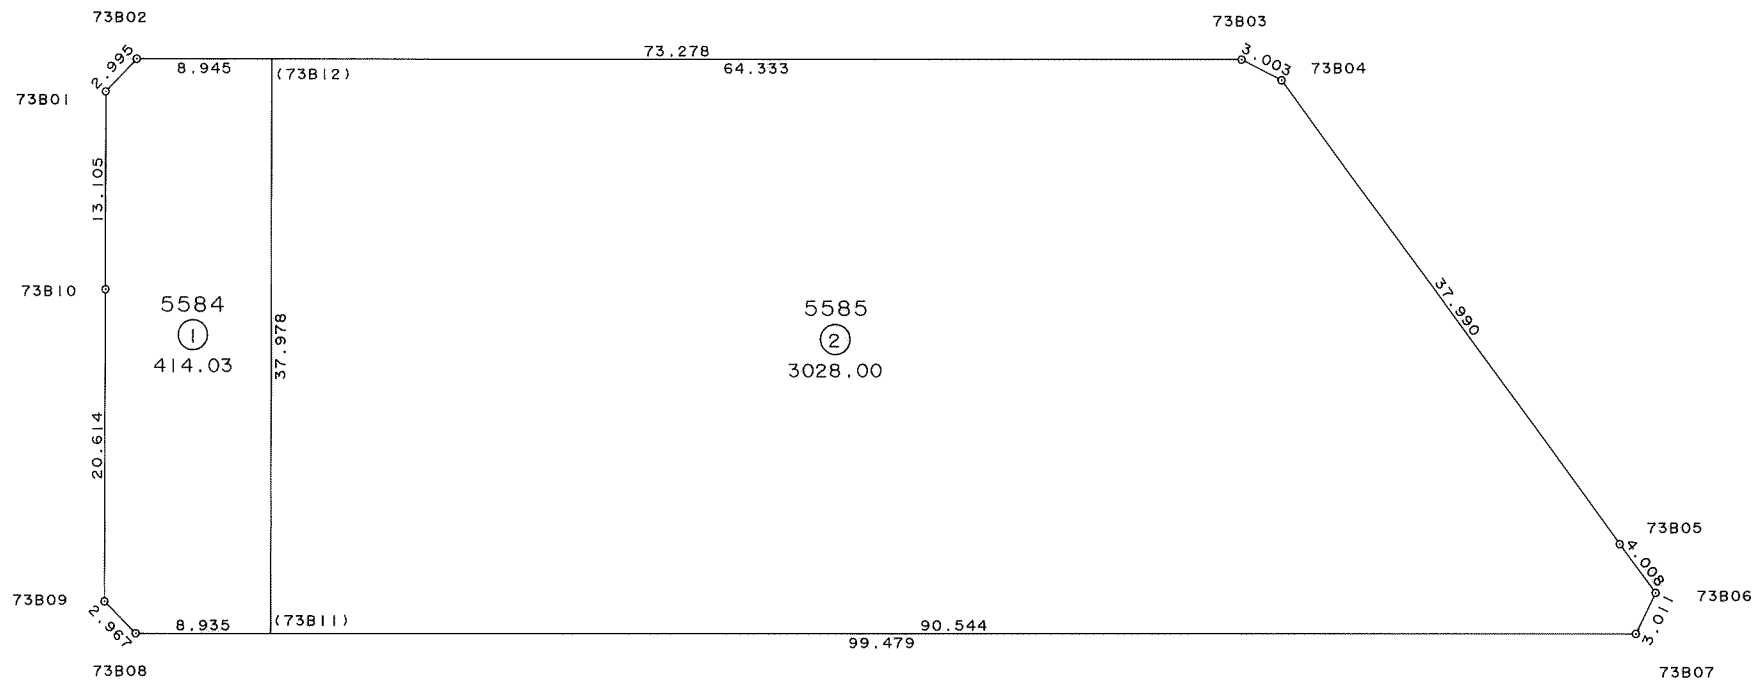

面積計算書

地番: 73-1

測点	X	Y	DX	DY	距離	方向角	夾角	倍横距	倍面積
73B02	30068.624	-37297.912	-0.565	-2.941	2.995	259-07-31	133-57-25	-2.941	1.661665
73B01	30068.059	-37300.853	-10.722	-7.535	13.105	215-05-53	135-58-22	-13.417	143.857074
73B10	30057.337	-37308.388	-16.847	-11.880	20.614	215-11-25	180-05-32	-32.832	553.120704
73B09	30040.490	-37320.268	-2.925	0.495	2.967	170-23-41	135-12-16	-44.217	129.334725
73B08	30037.565	-37319.773	-5.144	7.306	8.935	125-08-55	134-45-14	-36.416	187.323904
(73B11)	30032.421	-37312.467	31.051	21.867	37.978	35-09-15	90-00-20	-7.243	-224.902393
(73B12)	30063.472	-37290.600	5.152	-7.312	8.945	305-10-06	90-00-51	7.312	37.671424
合計					95.539		900-00-00		828.067103
								面積	414.033551
								坪数	125.245149

面積計算書

地番: 73-2

測点	X	Y	DX	DY	距離	方向角	夾角	倍横距	倍面積
(73B12)	30063.472	-37290.600	-31.051	-21.867	37.978	215-09-15	89-58-59	-21.867	678.992217
(73B11)	30032.421	-37312.467	-52.126	74.034	90.544	125-08-55	89-59-40	30.300	-1579.417800
73B07	29980.295	-37238.433	1.473	2.626	3.011	60-42-38	115-33-43	106.960	157.552080
73B06	29981.768	-37235.807	4.007	-0.094	4.008	358-39-22	117-56-44	109.492	438.734444
73B05	29985.775	-37235.901	37.983	-0.712	37.990	358-55-34	180-16-12	108.686	4128.220338
73B04	30023.758	-37236.613	2.657	-1.399	3.003	332-13-54	153-18-20	106.575	283.169775
73B03	30026.415	-37238.012	37.057	-52.588	64.333	305-10-16	152-56-22	52.588	1948.753516
合計					240.867		900-00-00		6056.004570
								面積	3028.002285
								坪数	915.970691