



画地出来形確認測量図

74街区

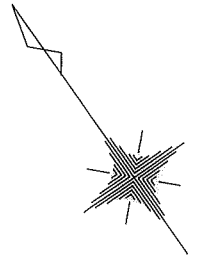

S=1:500

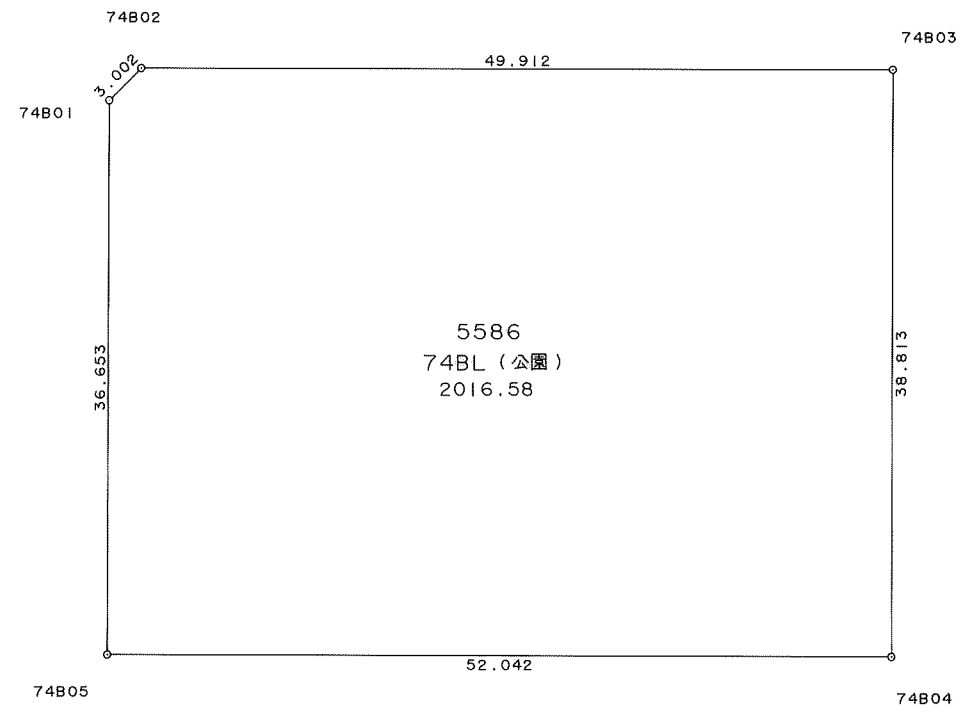

面積計算書

地番: 74BL

測点	X	Y	DX	DY	距離	方向角	夾角	倍横距	倍面積
74B02	30032.654	-37323.214	-0.525	-2.956	3.002	259-55-44	134-46-46	-2.956	1.551900
74B01	30032.129	-37326.170	-29.961	-21.113	36.653	215-10-18	135-14-34	-27.025	809.696025
74B05	30002.168	-37347.283	-29.985	42.535	52.042	125-10-55	90-00-37	-5.603	168.005955
74B04	29972.183	-37304.748	31.736	22.345	38.813	35-08-56	89-58-01	59.277	1881.214872
74B03	30003.919	-37282.403	28.735	-40.811	49.912	305-08-58	90-00-02	40.811	1172.704085
合計					180.422		540-00-00		4033.172837
								面積	2016.586418
								坪数	610.017391