



画地出来形確認測量図

83街区

2053.08m²

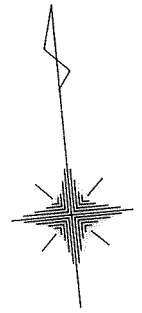

S=1:500

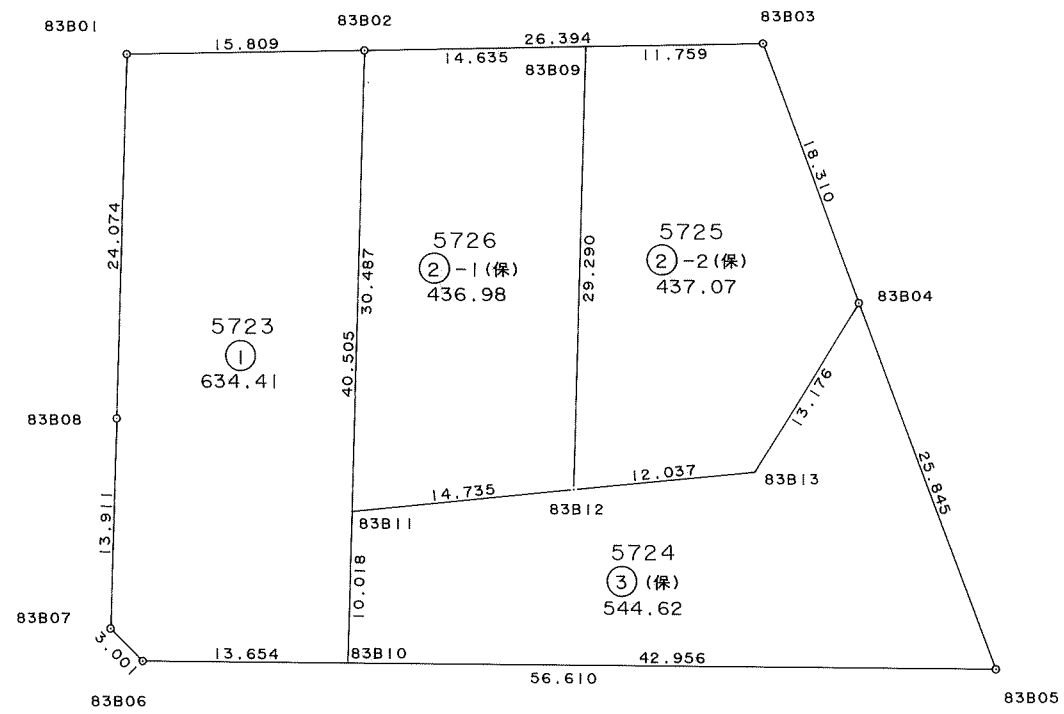

面積計算書

地番: 83-1

測点	X	Y	DX	DY	距離	方向角	夾角	倍横距	倍面積
83B01	29828.519	-37100.362	-23.885	-3.010	24.074	187-10-57	92-24-14	-3.010	71.893850
83B08	29804.634	-37103.372	-13.800	-1.757	13.911	187-15-21	180-04-24	-7.777	107.322600
83B07	29790.834	-37105.129	-2.342	1.877	3.001	141-17-22	134-02-01	-7.657	17.932694
83B06	29788.492	-37103.252	-1.476	13.574	13.654	96-12-21	134-54-59	7.794	-11.503944
83B10	29787.016	-37089.678	40.186	5.070	40.505	7-11-26	90-59-05	26.438	1062.437468
83B02	29827.202	-37084.608	1.317	-15.754	15.809	274-46-43	87-35-17	15.754	20.748018
合計					110.954		720-00-00		1268.830686
								面積	634.415343
								坪数	191.910641

面積計算書

地番: 83-2-1(保)

測点	X	Y	DX	DY	距離	方向角	夾角	倍横距	倍面積
83B02	29827.202	-37084.608	-30.247	-3.816	30.487	187-11-26	92-30-39	-3.816	115.422552
83B11	29796.955	-37088.424	-0.007	14.735	14.735	90-01-38	82-50-12	7.103	-0.049721
83B12	29796.948	-37073.689	29.060	3.667	29.290	7-11-31	97-09-53	25.505	741.175300
83B09	29826.008	-37070.022	1.194	-14.586	14.635	274-40-47	87-29-16	14.586	17.415684
合計					89.147		360-00-00		873.963815
								面積	436.981907
								坪数	132.187026

面積計算書

地番: 83-2-2(保)

測点	X	Y	DX	DY	距離	方向角	夾角	倍横距	倍面積
83B09	29826.008	-37070.022	-29.060	-3.667	29.290	187-11-31	92-30-51	-3.667	106.563020
83B12	29796.948	-37073.689	-0.042	12.037	12.037	90-12-00	83-00-29	4.703	-0.197526
83B13	29796.906	-37061.652	10.443	8.035	13.176	37-34-31	127-22-31	24.775	258.725325
83B04	29807.349	-37053.617	17.700	-4.685	18.310	345-10-28	127-35-57	28.125	497.812500
83B03	29825.049	-37058.302	0.959	-11.720	11.759	274-40-40	109-30-12	11.720	11.239480
合計					84.572		540-00-00		874.142799
								面積	437.071399
								坪数	132.214098

面積計算書

地番: 83-3(保)

測点	X	Y	DX	DY	距離	方向角	夾角	倍横距	倍面積
83B11	29796.955	-37088.424	-9.939	-1.254	10.018	187-11-28	97-09-50	-1.254	12.463506
83B10	29787.016	-37089.678	-4.644	42.704	42.956	96-12-23	89-00-55	40.196	-186.670224
83B05	29782.372	-37046.974	24.977	-6.643	25.845	345-06-22	68-53-59	76.257	1904.671089
83B04	29807.349	-37053.617	-10.443	-8.035	13.176	217-34-31	52-28-09	61.579	-643.069497
83B13	29796.906	-37061.652	0.042	-12.037	12.037	270-12-00	232-37-29	41.507	1.743294
83B12	29796.948	-37073.689	0.007	-14.735	14.735	270-01-38	179-49-38	14.735	0.103145
合計					118.767		720-00-00		1089.241313
								面積	544.620656
								坪数	164.747748