


竜内土地区画整理事業画地出来形確認測量図 1



- 1
- 2
- 3

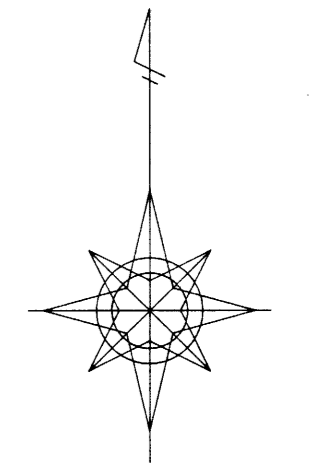

S=1:500