
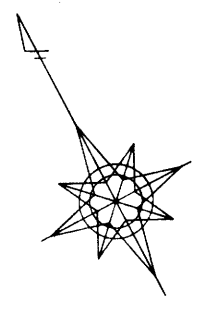
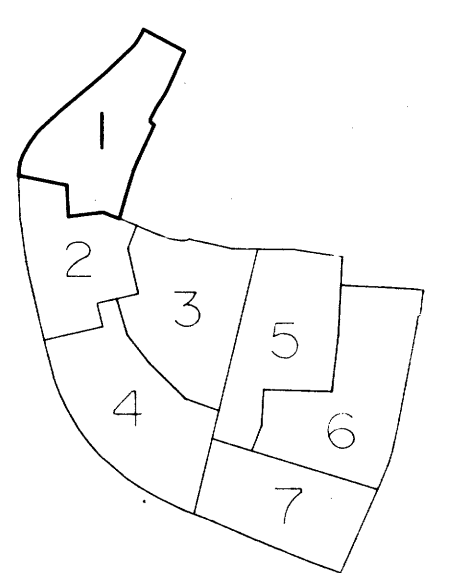


尾島町今井土地区画整理事業 出来形確認測量図



平成七年三月作製

西毛測量株式会社

新田郡尾島町役場

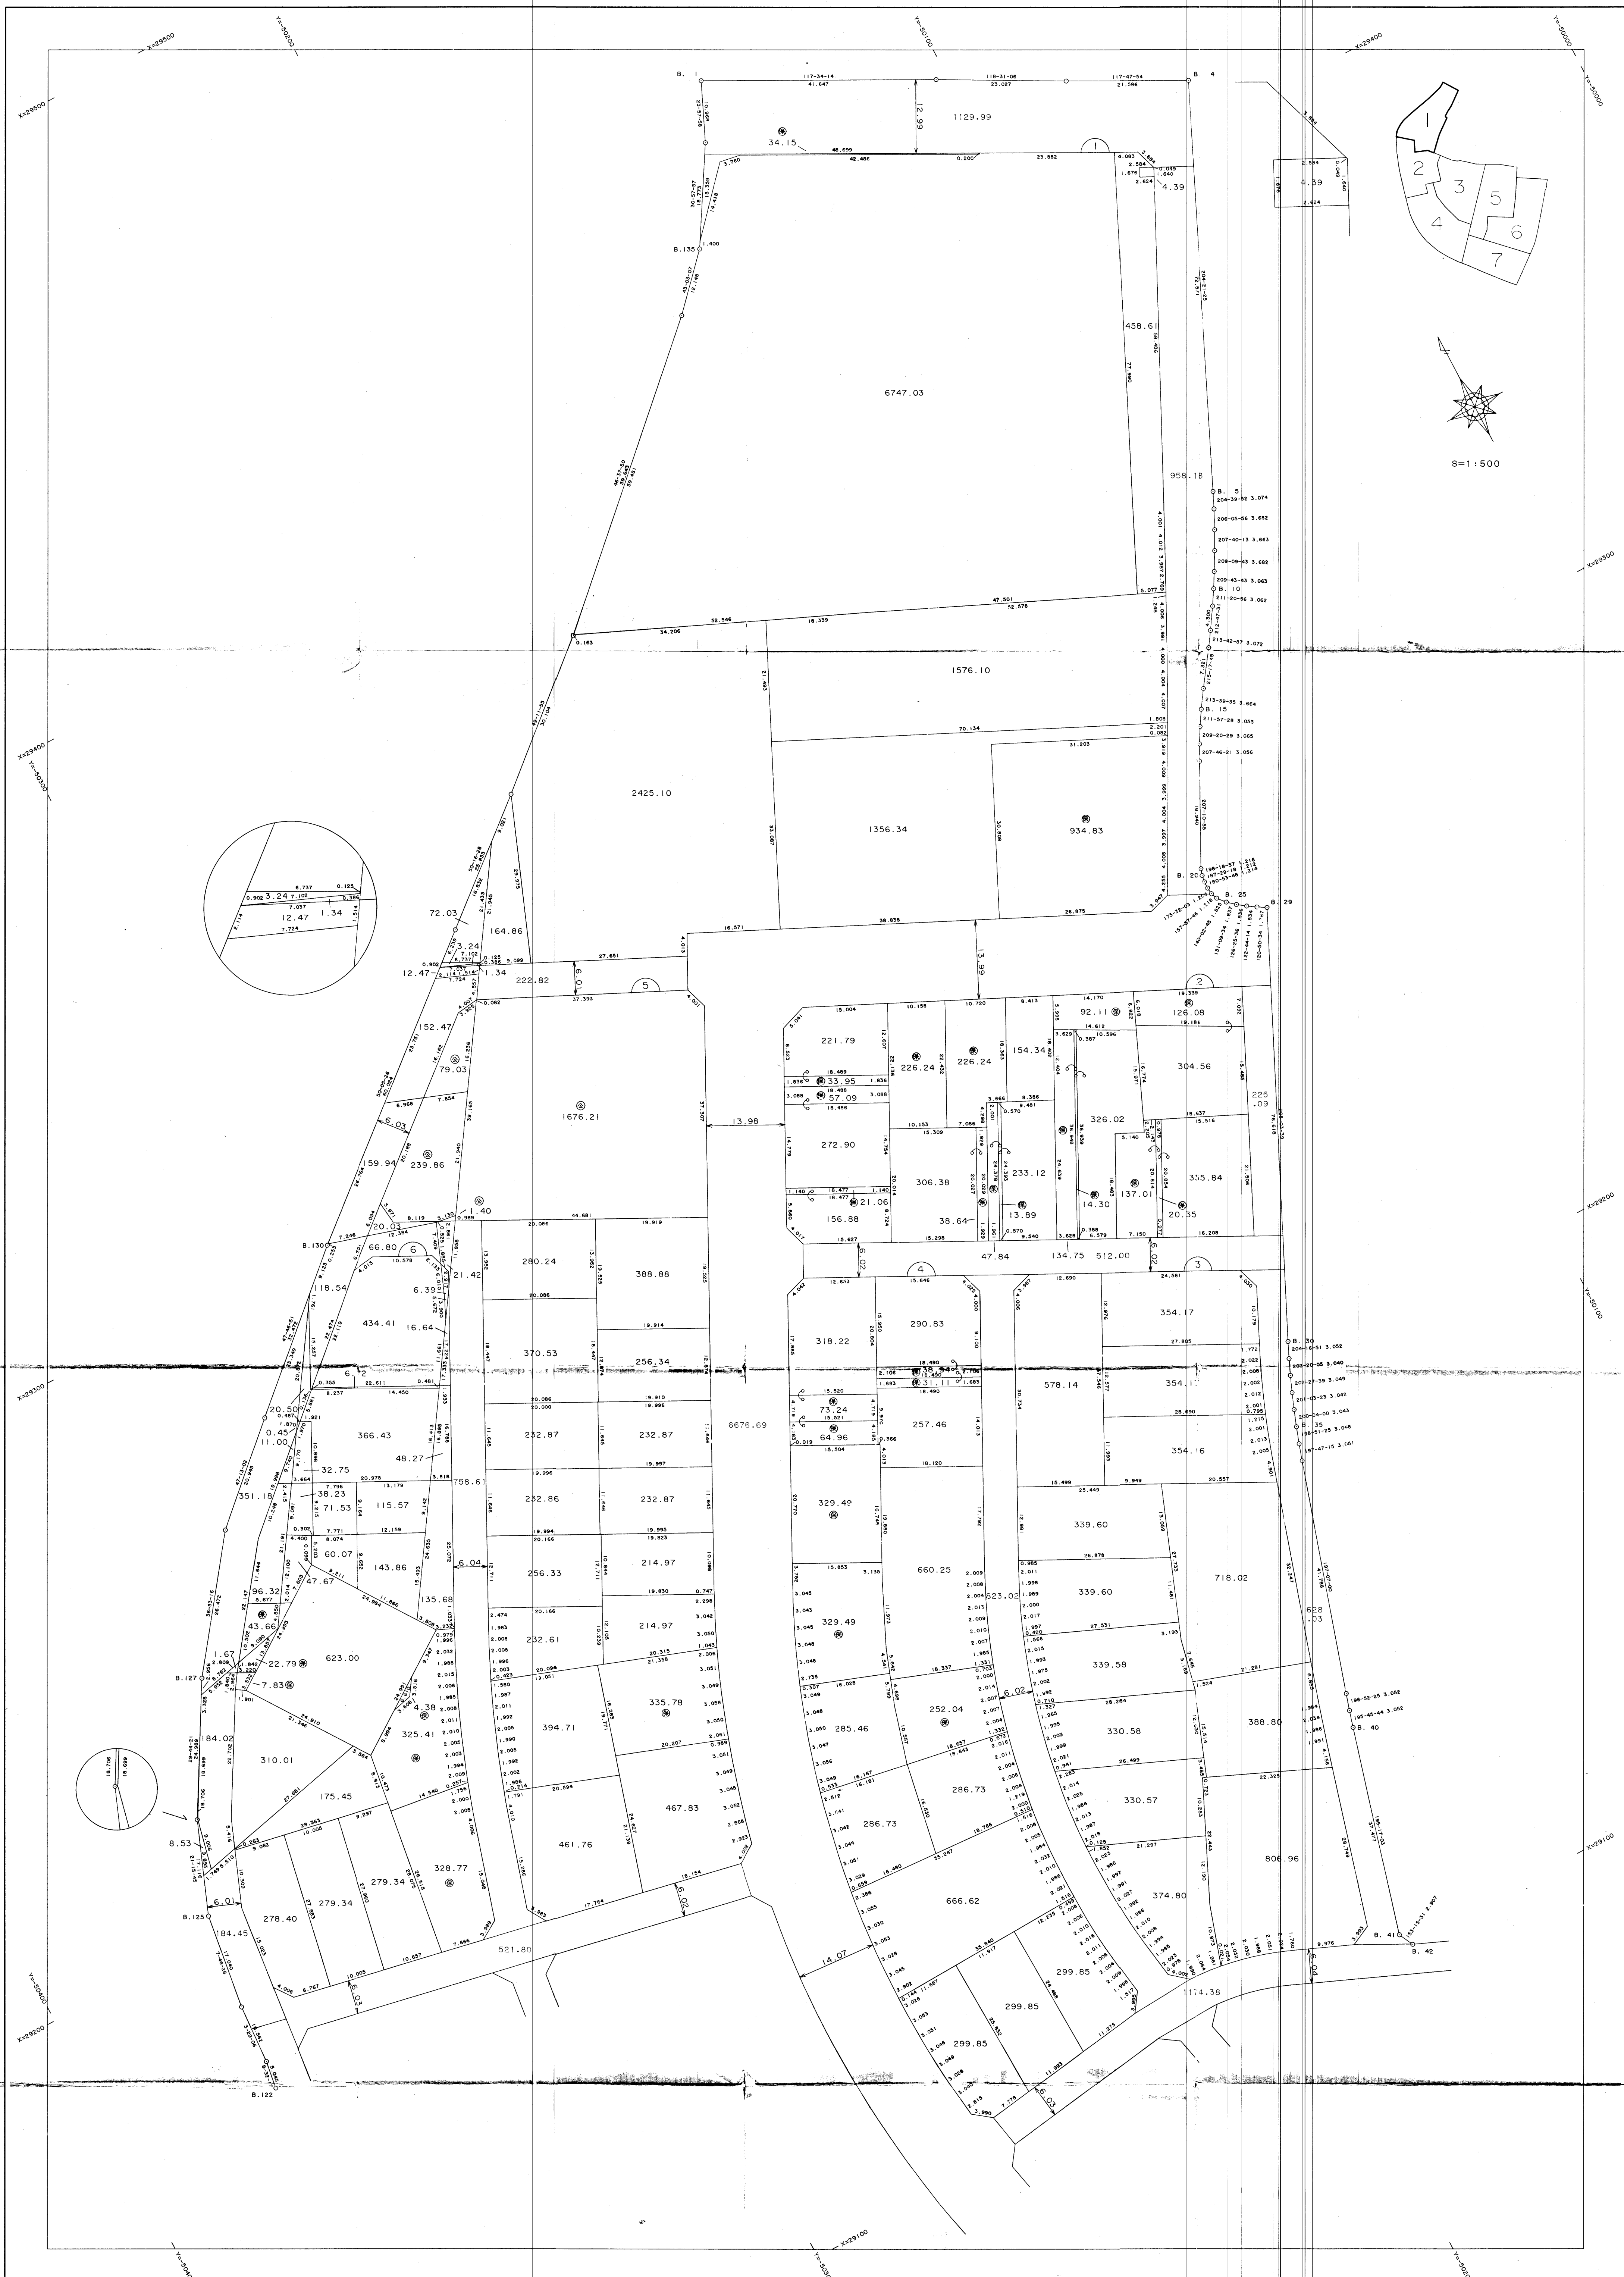

S=1:500

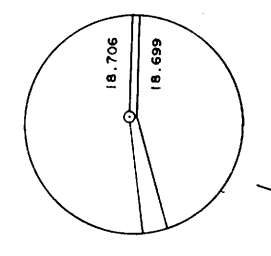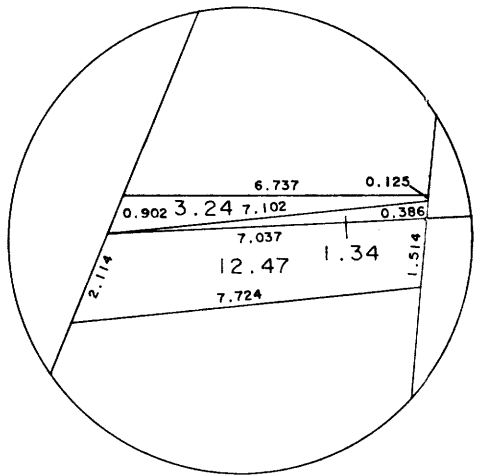

X=29500 X=30000 X=30500 X=50000