



画地出来形確認測量図

23街区

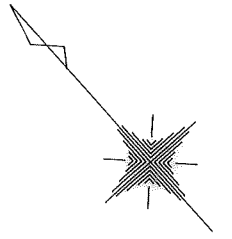

S=1:1000

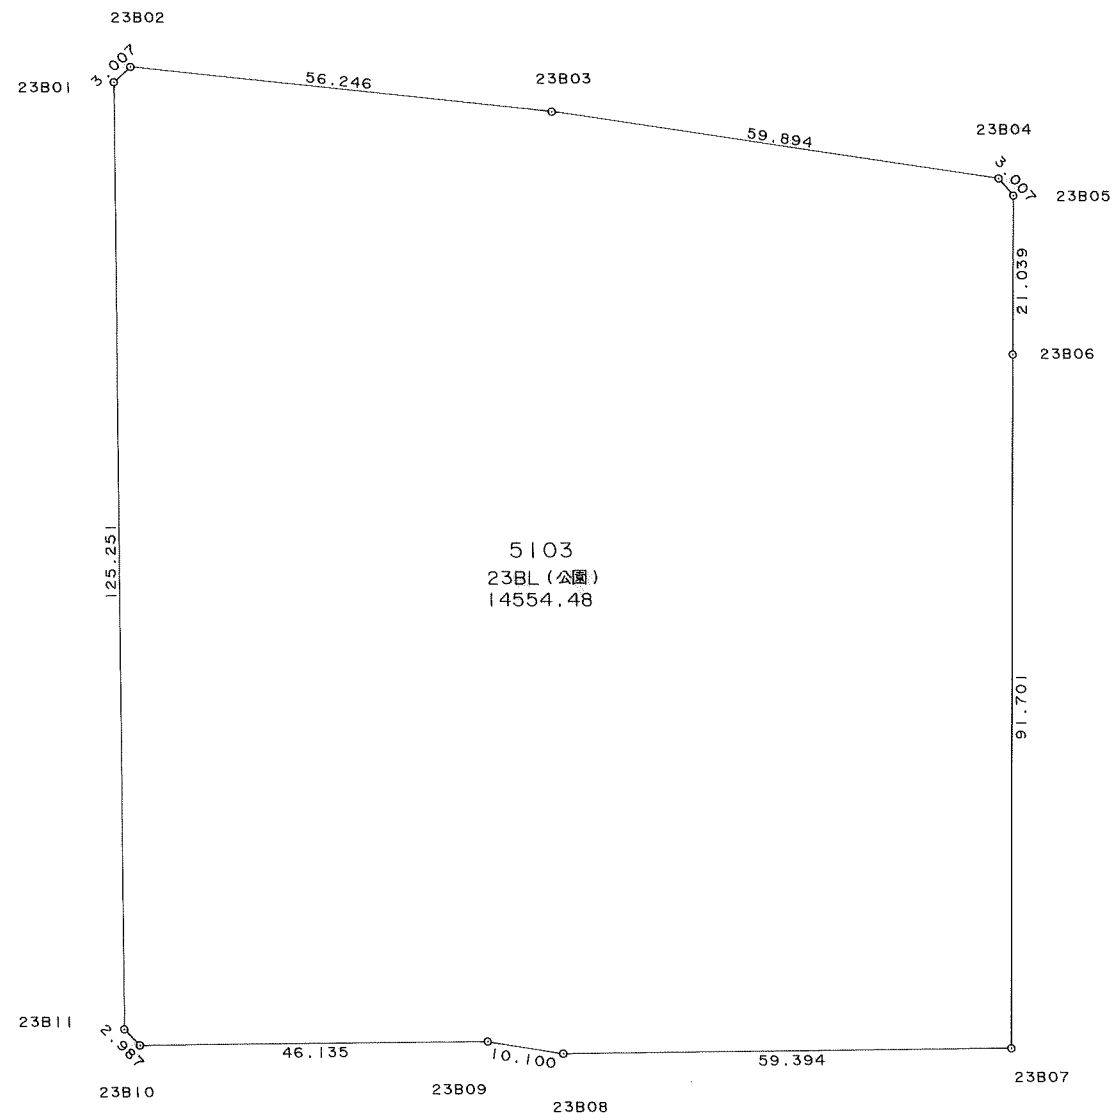

面積計算書

地番: 23BL

測点	X	Y	DX	DY	距離	方向角	夾角	倍横距	倍面積
23B11	30653.779	-38190.579	-2.981	0.182	2.987	176-30-22	135-24-06	0.182	-0.542542
23B10	30650.798	-38190.397	-30.378	34.722	46.135	131-10-57	134-40-35	35.086	-1065.842508
23B09	30620.420	-38155.675	-7.831	6.379	10.100	140-50-04	189-39-07	76.187	-596.620397
23B08	30612.589	-38149.296	-39.058	44.745	59.394	131-07-04	170-17-00	127.311	-4972.513038
23B07	30573.531	-38104.551	68.250	61.246	91.701	41-54-15	90-47-11	233.302	15922.861500
23B06	30641.781	-38043.305	15.644	14.068	21.039	41-57-49	180-03-34	308.616	4827.988704
23B05	30657.425	-38029.237	3.007	0.040	3.007	0-45-44	138-47-55	322.724	970.431068
23B04	30660.432	-38029.197	46.089	-38.250	59.894	320-18-37	139-32-53	284.514	13112.965746
23B03	30706.521	-38067.447	41.668	-37.781	56.246	317-48-03	177-29-26	208.483	8687.069644
23B02	30748.189	-38105.228	-0.032	-3.007	3.007	269-23-25	131-35-22	167.695	-5.366240
23B01	30748.157	-38108.235	-94.378	-82.344	125.251	221-06-16	131-42-51	82.344	-7771.462032
合計					478.761		1620-00-00		29108.969905
								面積	14554.484952
								坪数	4402.731697