



画地出来形確認測量図

27街区

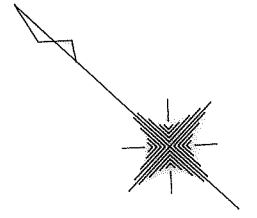

3393.49m<sup>2</sup>

S=1:500

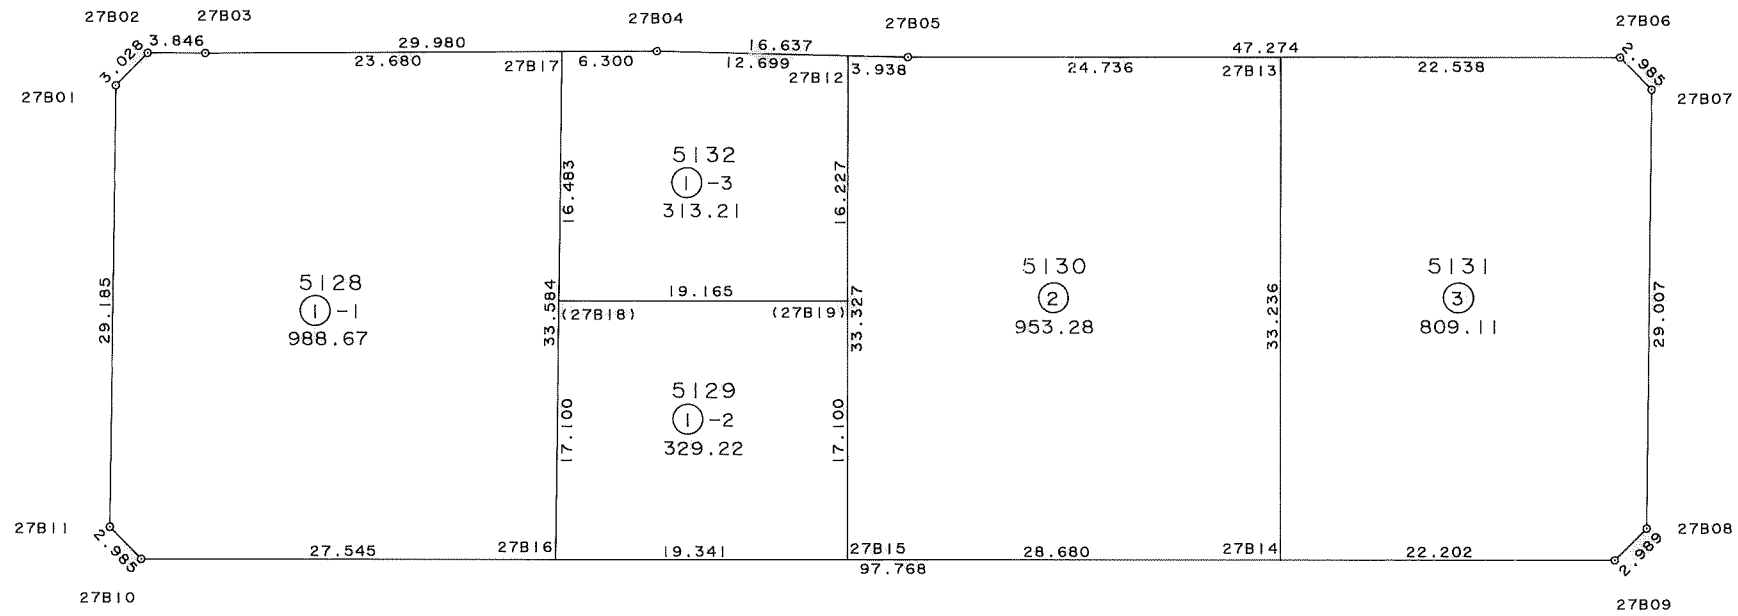

面積計算書

地番: 27-1-1

測点	X	Y	DX	DY	距離	方向角	夾角	倍横距	倍面積
27B02	30794.985	-37960.053	0.126	-3.025	3.028	272-23-07	134-17-50	-3.025	-0.381150
27B01	30795.111	-37963.078	-19.352	-21.846	29.185	228-27-51	136-04-44	-27.896	539.843392
27B11	30775.759	-37984.924	-2.980	-0.170	2.985	183-15-54	134-48-03	-49.912	148.737760
27B10	30772.779	-37985.094	-20.408	18.500	27.545	137-48-27	134-32-33	-31.582	644.525456
27B16	30752.371	-37966.594	22.298	25.113	33.584	48-23-52	90-35-25	12.031	268.267238
27B17	30774.669	-37941.481	17.454	-16.003	23.680	317-29-00	89-05-08	21.141	368.995014
27B03	30792.123	-37957.484	2.862	-2.569	3.846	318-05-17	180-36-17	2.569	7.352478
合計					123.853		900-00-00		1977.340188
								面積	988.670094
								坪数	299.072703

面積計算書

地番: 27-1-2

測点	X	Y	DX	DY	距離	方向角	夾角	倍横距	倍面積
(27B18)	30763.725	-37953.807	-11.354	-12.787	17.100	228-23-49	90-35-26	-12.787	145.183598
27B16	30752.371	-37966.594	-14.330	12.990	19.341	137-48-29	89-24-40	-12.584	180.328720
27B15	30738.041	-37953.604	11.485	12.669	17.100	47-48-23	89-59-54	13.075	150.166375
(27B19)	30749.526	-37940.935	14.199	-12.872	19.165	317-48-23	90-00-00	12.872	182.769528
合計					72.706		360-00-00		658.448221
								面積	329.224110
								坪数	99.590293

面積計算書

地番: 27-1-3

測点	X	Y	DX	DY	距離	方向角	夾角	倍横距	倍面積
27B17	30774.669	-37941.481	-10.944	-12.326	16.483	228-23-56	90-55-20	-12.326	134.895744
(27B18)	30763.725	-37953.807	-14.199	12.872	19.165	137-48-23	89-24-27	-11.780	167.264220
(27B19)	30749.526	-37940.935	10.898	12.023	16.227	47-48-36	90-00-13	13.115	142.927270
27B12	30760.424	-37928.912	9.602	-8.311	12.699	319-07-20	91-18-44	16.827	161.572854
27B04	30770.026	-37937.223	4.643	-4.258	6.300	317-28-36	178-21-16	4.258	19.769894
合計					70.874		540-00-00		626.429982
								面積	313.214991
								坪数	94.747534

面積計算書

地番: 27-2

測点	X	Y	DX	DY	距離	方向角	夾角	倍横距	倍面積
27B12	30760.424	-37928.912	-22.383	-24.692	33.327	227-48-29	88-40-45	-24.692	552.681036
27B15	30738.041	-37953.604	-21.249	19.262	28.680	137-48-29	90-00-00	-30.122	640.062378
27B14	30716.792	-37934.342	22.327	24.620	33.236	47-47-46	89-59-17	13.760	307.219520
27B13	30739.119	-37909.722	18.327	-16.613	24.736	317-48-30	90-00-44	21.767	398.923809
27B05	30757.446	-37926.335	2.978	-2.577	3.938	319-07-44	181-19-14	2.577	7.674306
合計					123.917		540-00-00		1906.561049
								面積	953.280524
								坪数	288.367358

面積計算書

地番: 27-3

測点	X	Y	DX	DY	距離	方向角	夾角	倍横距	倍面積
27B13	30739.119	-37909.722	-22.327	-24.620	33.236	227-47-46	89-59-07	-24.620	549.690740
27B14	30716.792	-37934.342	-16.449	14.911	22.202	137-48-28	90-00-42	-34.329	564.677721
27B09	30700.343	-37919.431	-0.159	2.985	2.989	93-02-57	135-14-29	-16.433	2.612847
27B08	30700.184	-37916.446	19.256	21.694	29.007	48-24-26	135-21-29	8.246	158.784976
27B07	30719.440	-37894.752	2.980	0.166	2.985	3-11-18	134-46-52	30.106	89.715880
27B06	30722.420	-37894.586	16.699	-15.136	22.538	317-48-39	134-37-21	15.136	252.756064
合計					112.957		720-00-00		1618.238228
								面積	809.119114
								坪数	244.758531