



画地出来形確認測量図

36街区

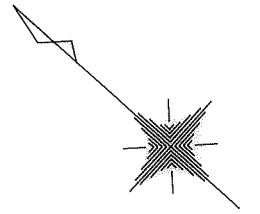

1183.07m²

S=1:500

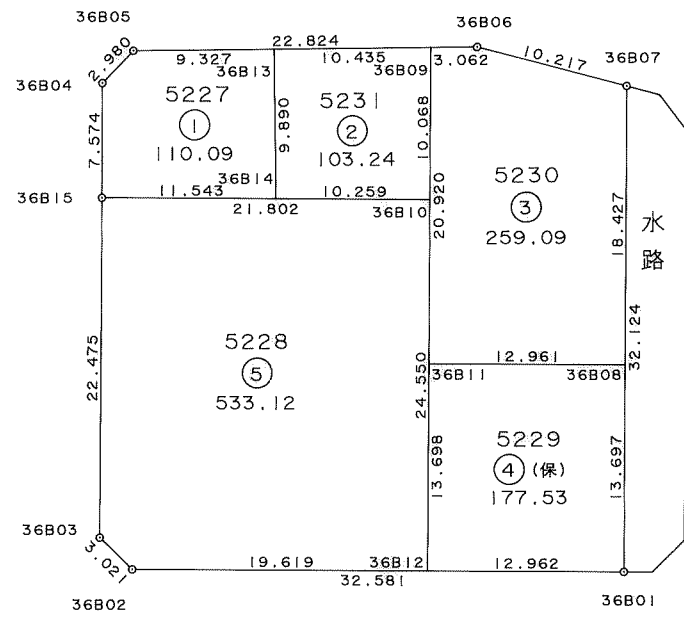

面積計算書

地番: 36-1

測点	X	Y	DX	DY	距離	方向角	夾角	倍横距	倍面積
36B15	30630.922	-37822.467	-8.634	7.662	11.543	138-24-48	90-07-38	7.662	-66.153708
36B14	30622.288	-37814.805	6.695	7.280	9.890	47-23-49	88-59-01	22.604	151.333780
36B13	30628.983	-37807.525	6.869	-6.310	9.327	317-25-44	90-01-55	23.574	161.929806
36B05	30635.852	-37813.835	0.110	-2.978	2.980	272-06-55	134-41-11	14.286	1.571460
36B04	30635.962	-37816.813	-5.040	-5.654	7.574	228-17-10	136-10-15	5.654	-28.496160
合計					41.314		540-00-00		220.185178
								面積 坪数	110.092589 33.303008

面積計算書

地番: 36-2

測点	X	Y	DX	DY	距離	方向角	夾角	倍横距	倍面積
36B14	30622.288	-37814.805	-7.673	6.809	10.259	138-24-51	91-01-02	6.809	-52.245457
36B10	30614.615	-37807.996	6.683	7.530	10.068	48-24-37	89-59-46	21.148	141.332084
36B09	30621.298	-37800.466	7.685	-7.059	10.435	317-25-52	89-01-15	21.619	166.142015
36B13	30628.983	-37807.525	-6.695	-7.280	9.890	227-23-49	89-57-57	7.280	-48.739600
合計					40.652		360-00-00		206.489042
								面積 坪数	103.244521 31.231467

面積計算書

地番: 36-3

測点	X	Y	DX	DY	距離	方向角	夾角	倍横距	倍面積
36B11	30607.412	-37816.113	-9.691	8.606	12.961	138-23-37	89-58-52	8.606	-83.400746
36B08	30597.721	-37807.507	12.234	13.780	18.427	48-24-04	90-00-27	30.992	379.156128
36B07	30609.955	-37793.727	9.088	-4.668	10.217	332-48-47	104-24-43	40.104	364.465152
36B06	30619.043	-37798.395	2.255	-2.071	3.062	317-26-08	164-37-21	33.365	75.238075
36B09	30621.298	-37800.466	-13.886	-15.647	20.920	228-24-45	90-58-37	15.647	-217.274242
合計					65.587		540-00-00		518.184367
								面積 坪数	259.092183 78.375385

面積計算書

地番: 36-4(保)

測点	X	Y	DX	DY	距離	方向角	夾角	倍横距	倍面積
36B12	30598.319	-37826.358	-9.691	8.608	12.962	138-23-13	89-58-40	8.608	-83.420128
36B01	30588.628	-37817.750	9.093	10.243	13.697	48-24-13	90-01-00	27.459	249.684687
36B08	30597.721	-37807.507	9.691	-8.606	12.961	318-23-37	89-59-24	29.096	281.969336
36B11	30607.412	-37816.113	-9.093	-10.245	13.698	228-24-33	90-00-56	10.245	-93.157785
合計					53.318		360-00-00		355.076110
								面積	177.538055
								坪数	53.705261

面積計算書

地番: 36-5

測点	X	Y	DX	DY	距離	方向角	夾角	倍横距	倍面積
36B03	30616.005	-37839.278	-3.019	-0.110	3.021	182-05-12	133-40-14	-0.110	0.332090
36B02	30612.986	-37839.388	-14.667	13.030	19.619	138-22-57	136-17-45	12.810	-187.884270
36B12	30598.319	-37826.358	16.296	18.362	24.550	48-24-41	90-01-44	44.202	720.315792
36B10	30614.615	-37807.996	16.307	-14.471	21.802	318-24-50	90-00-09	48.093	784.252551
36B15	30630.922	-37822.467	-14.917	-16.811	22.475	228-24-58	90-00-08	16.811	-250.769687
合計					91.467		540-00-00		1066.246476
								面積	533.123238
								坪数	161.269779