



画地出来形確認測量図

37街区

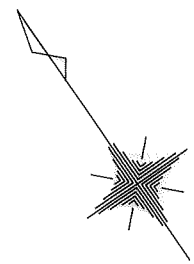

S=1:500

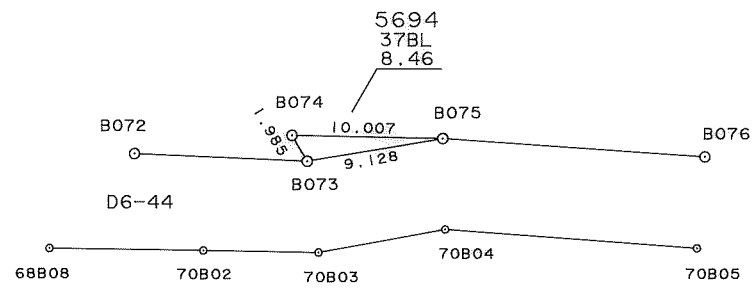

面積計算書

地番: 37BL

測点	X	Y	DX	DY	距離	方向角	夾角	倍横距	倍面積
B074	30099.053	-37175.546	-1.979	-0.152	1.985	184-23-31	58-30-13	-0.152	0.300808
B073	30097.074	-37175.698	-3.887	8.259	9.128	115-12-12	110-48-41	7.955	-30.921085
B075	30093.187	-37167.439	5.866	-8.107	10.007	305-53-18	10-41-06	8.107	47.555662
合計					21.120		180-00-00		16.935385
								面積	8.467692
								坪数	2.561476